

Approved
by BQ
6/2000

Boylan ~~5-3~~

1/8

H-32

KINDLY REPLACE
as SHOWN

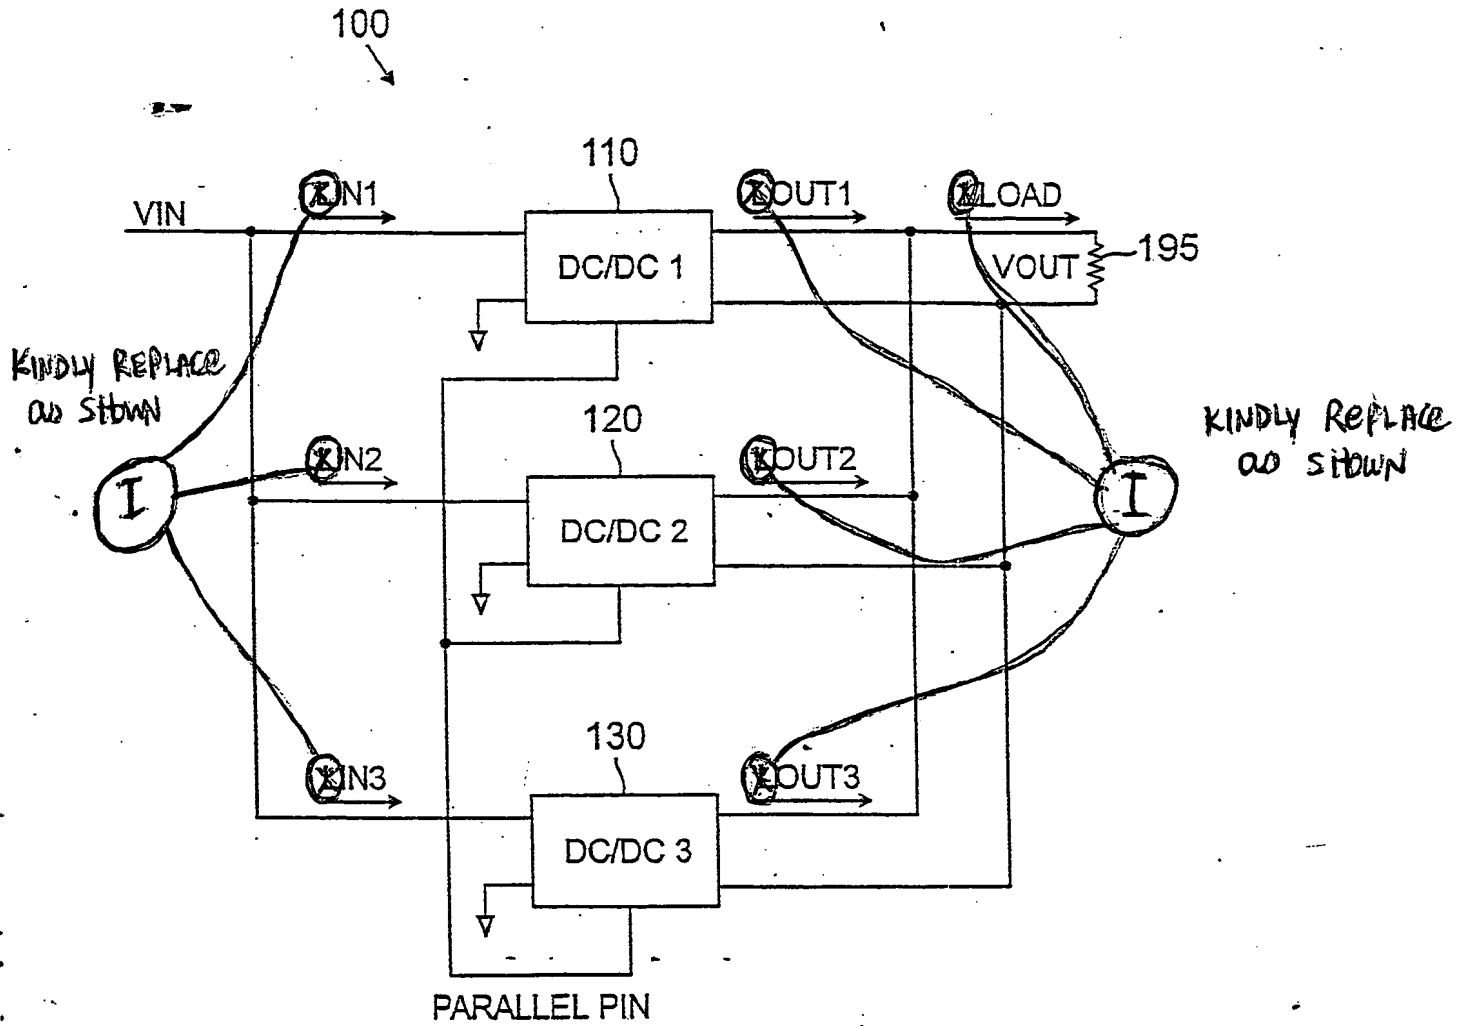


FIG. 1

Approved
by B.P.
6/2000

Boylan

5/3

2/8

11-32

KINDLY REPLACE
as shown

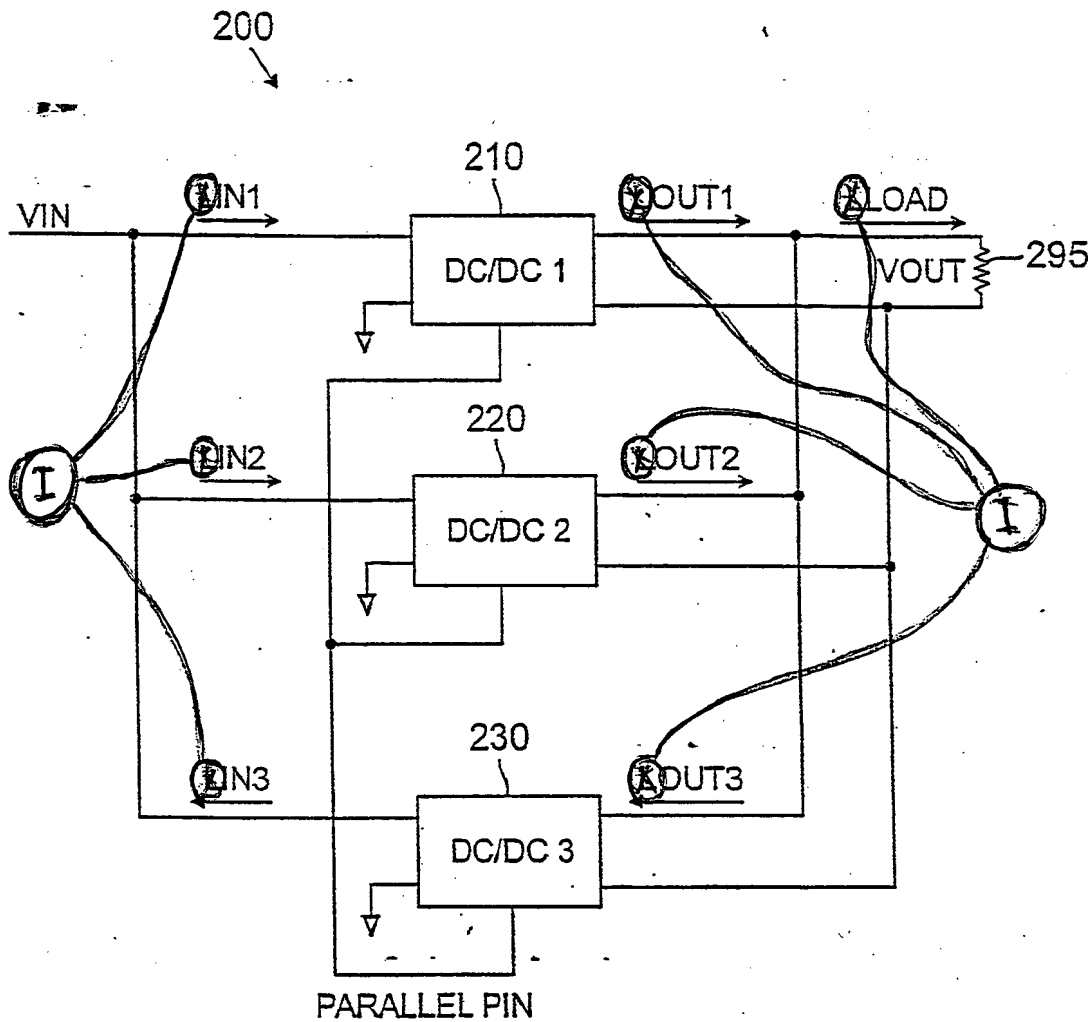


FIG. 2



Approved
by BGP
6/2000

Boylan 5/13

3/8

11-32

KINDLY REPLACE
AS SHOWN

KINDLY REPLACE
AS SHOWN

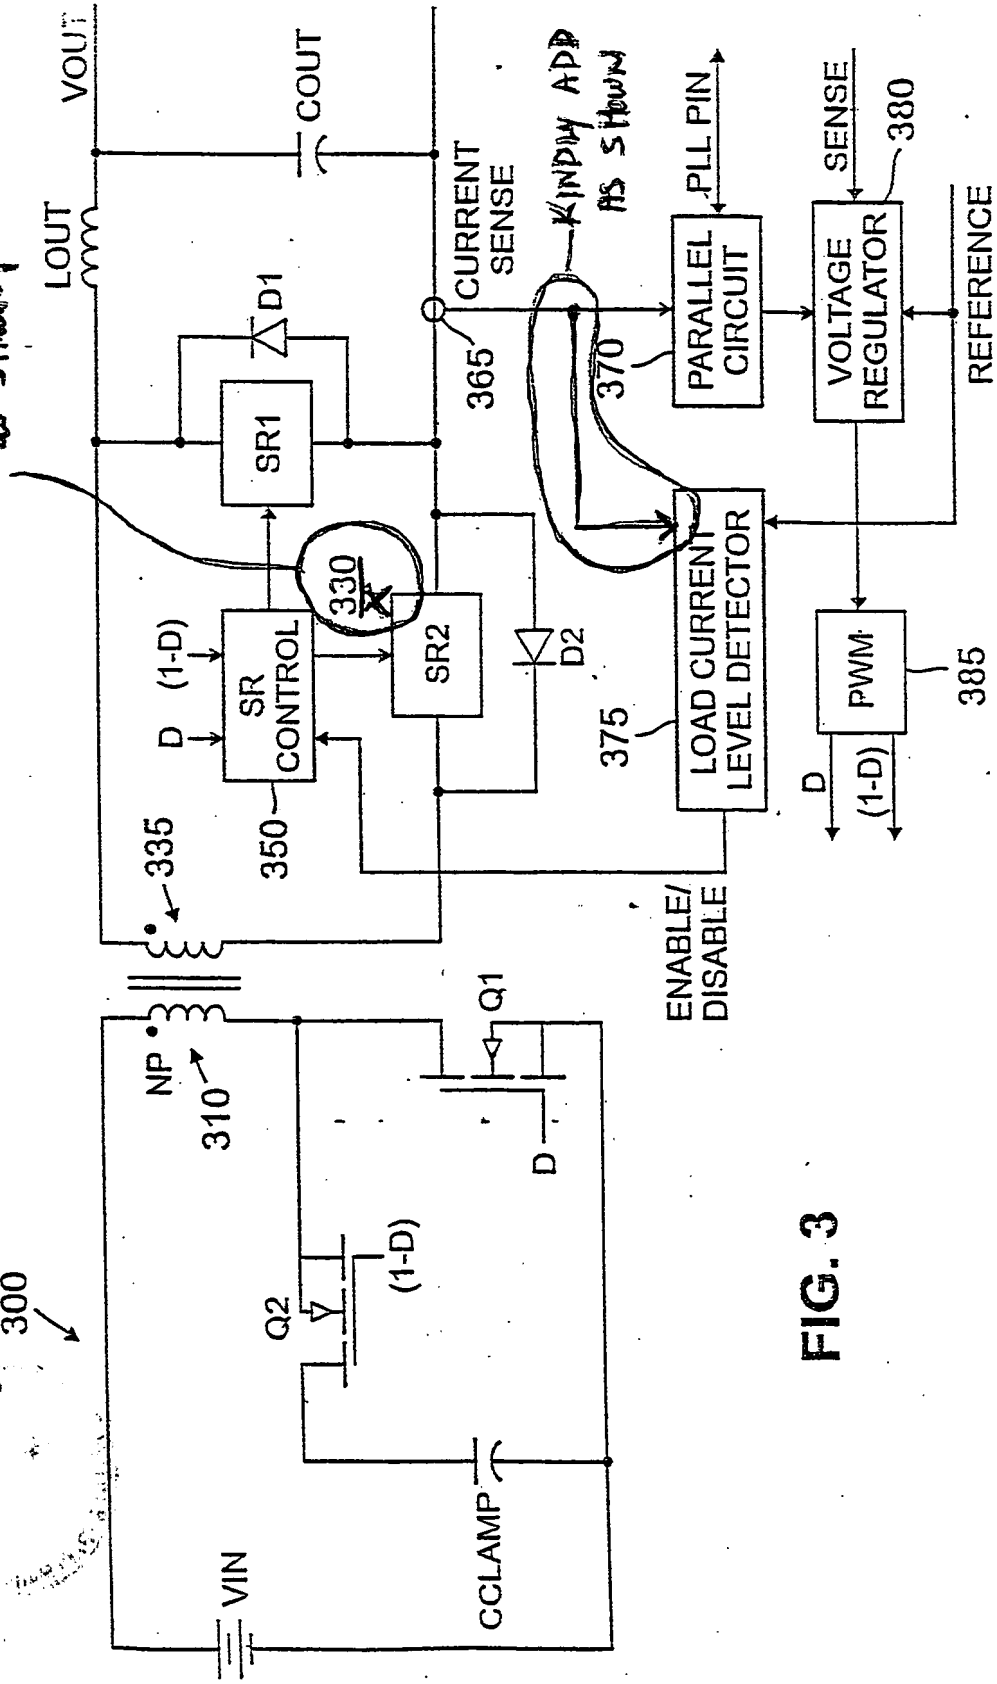


FIG. 3

Approved
by B.P.
6/2000

Boylan 543

4/8

11-32

KINDLY REPLACE
AS SHOWN

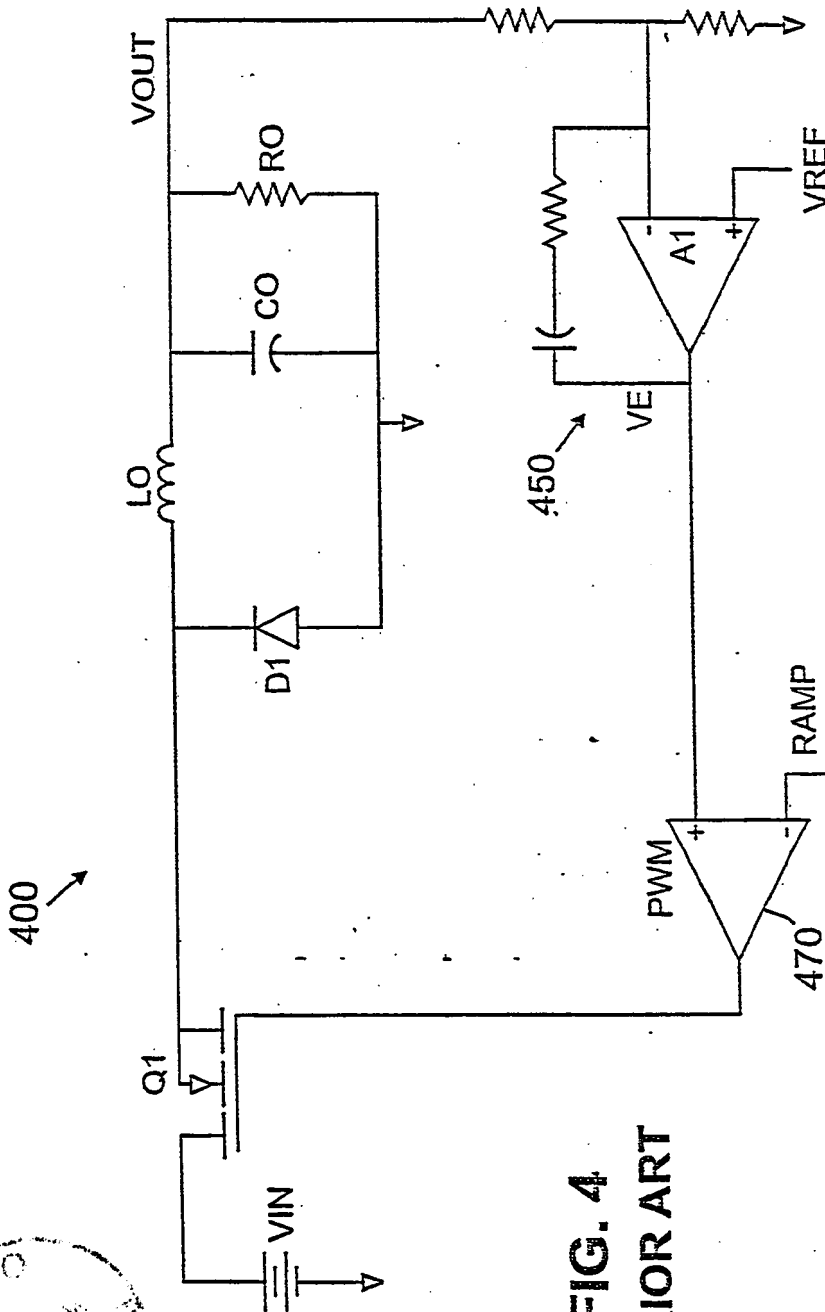


FIG. 4
PRIOR ART

Approved
by BP
6/2000

Boylan

5/13

5/8

11-32

KINDLY REPLACE
AS SHOWN

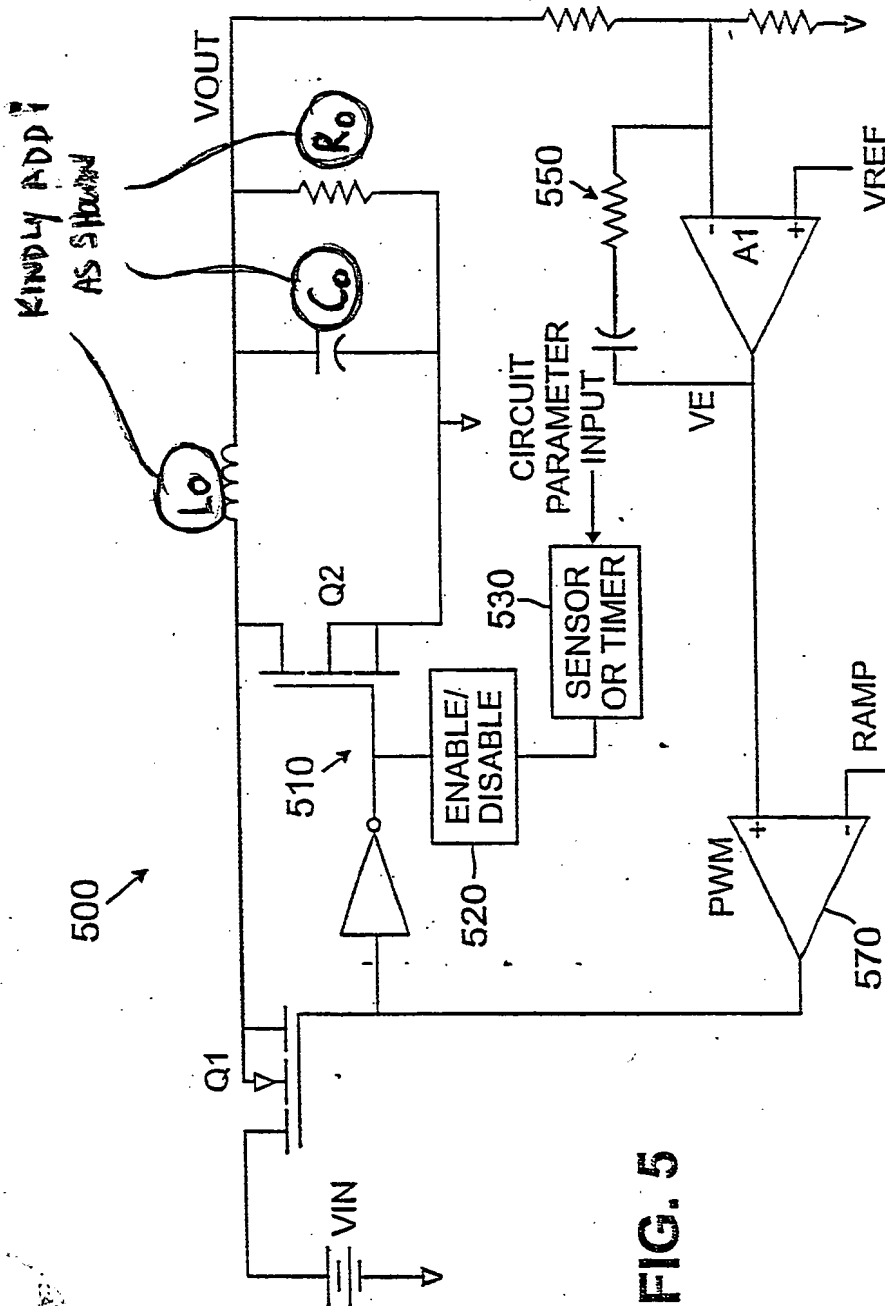


FIG. 5

600

KINDLY REPLACE CO SHOWN

Approved
by B.P.
6/2000

Boylan 5X13

6/8

11-32

KINDLY REPLACE
CO SHOWN

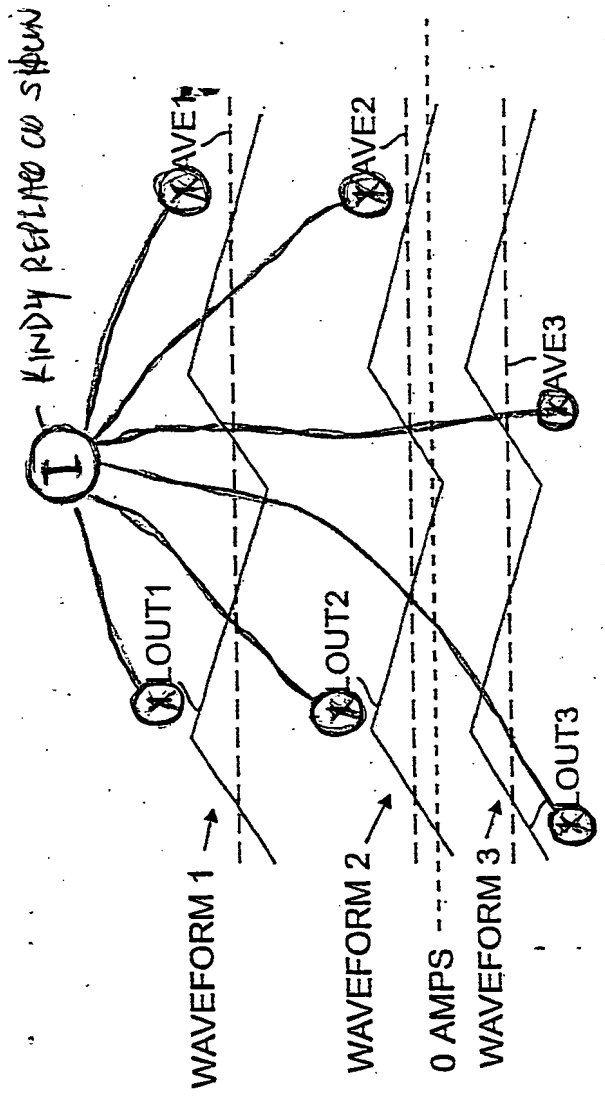


FIG. 6

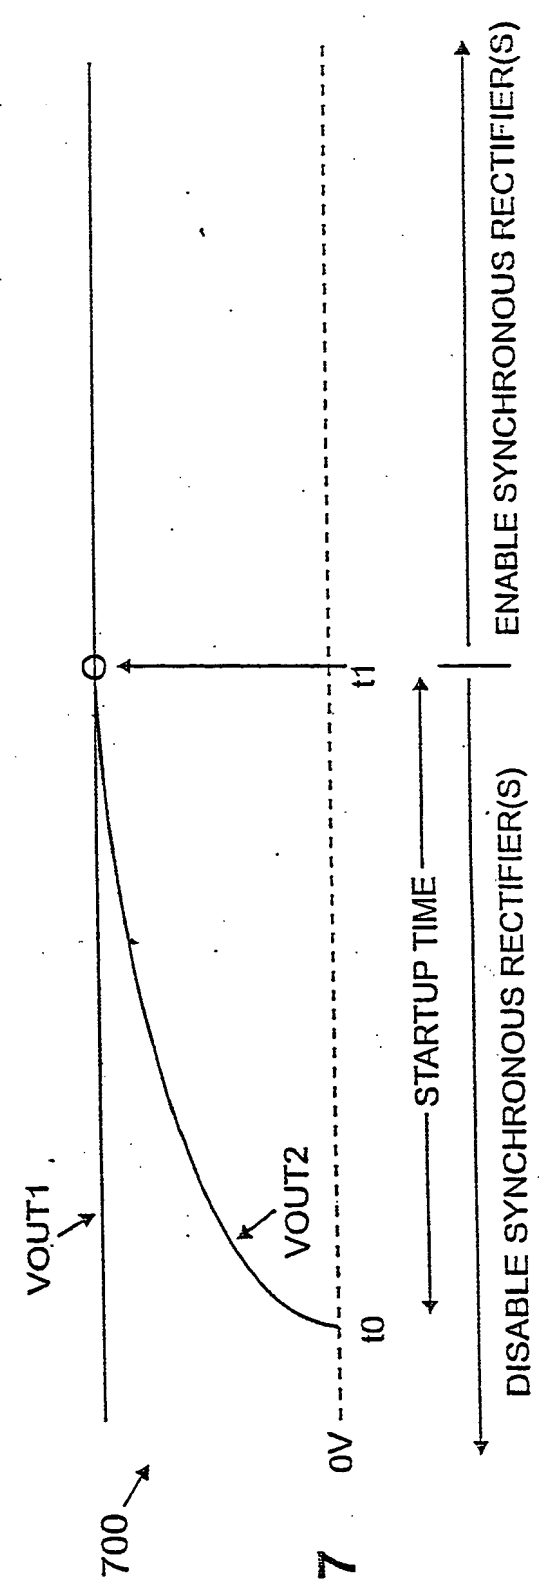


FIG. 7

Approved
by B.G.
6/2000

Boyian 5X13

(H-32)

KINDLY REPLACE
AS SHOWN

7/8

KINDLY ADD
RED LINES
AS SHOWN

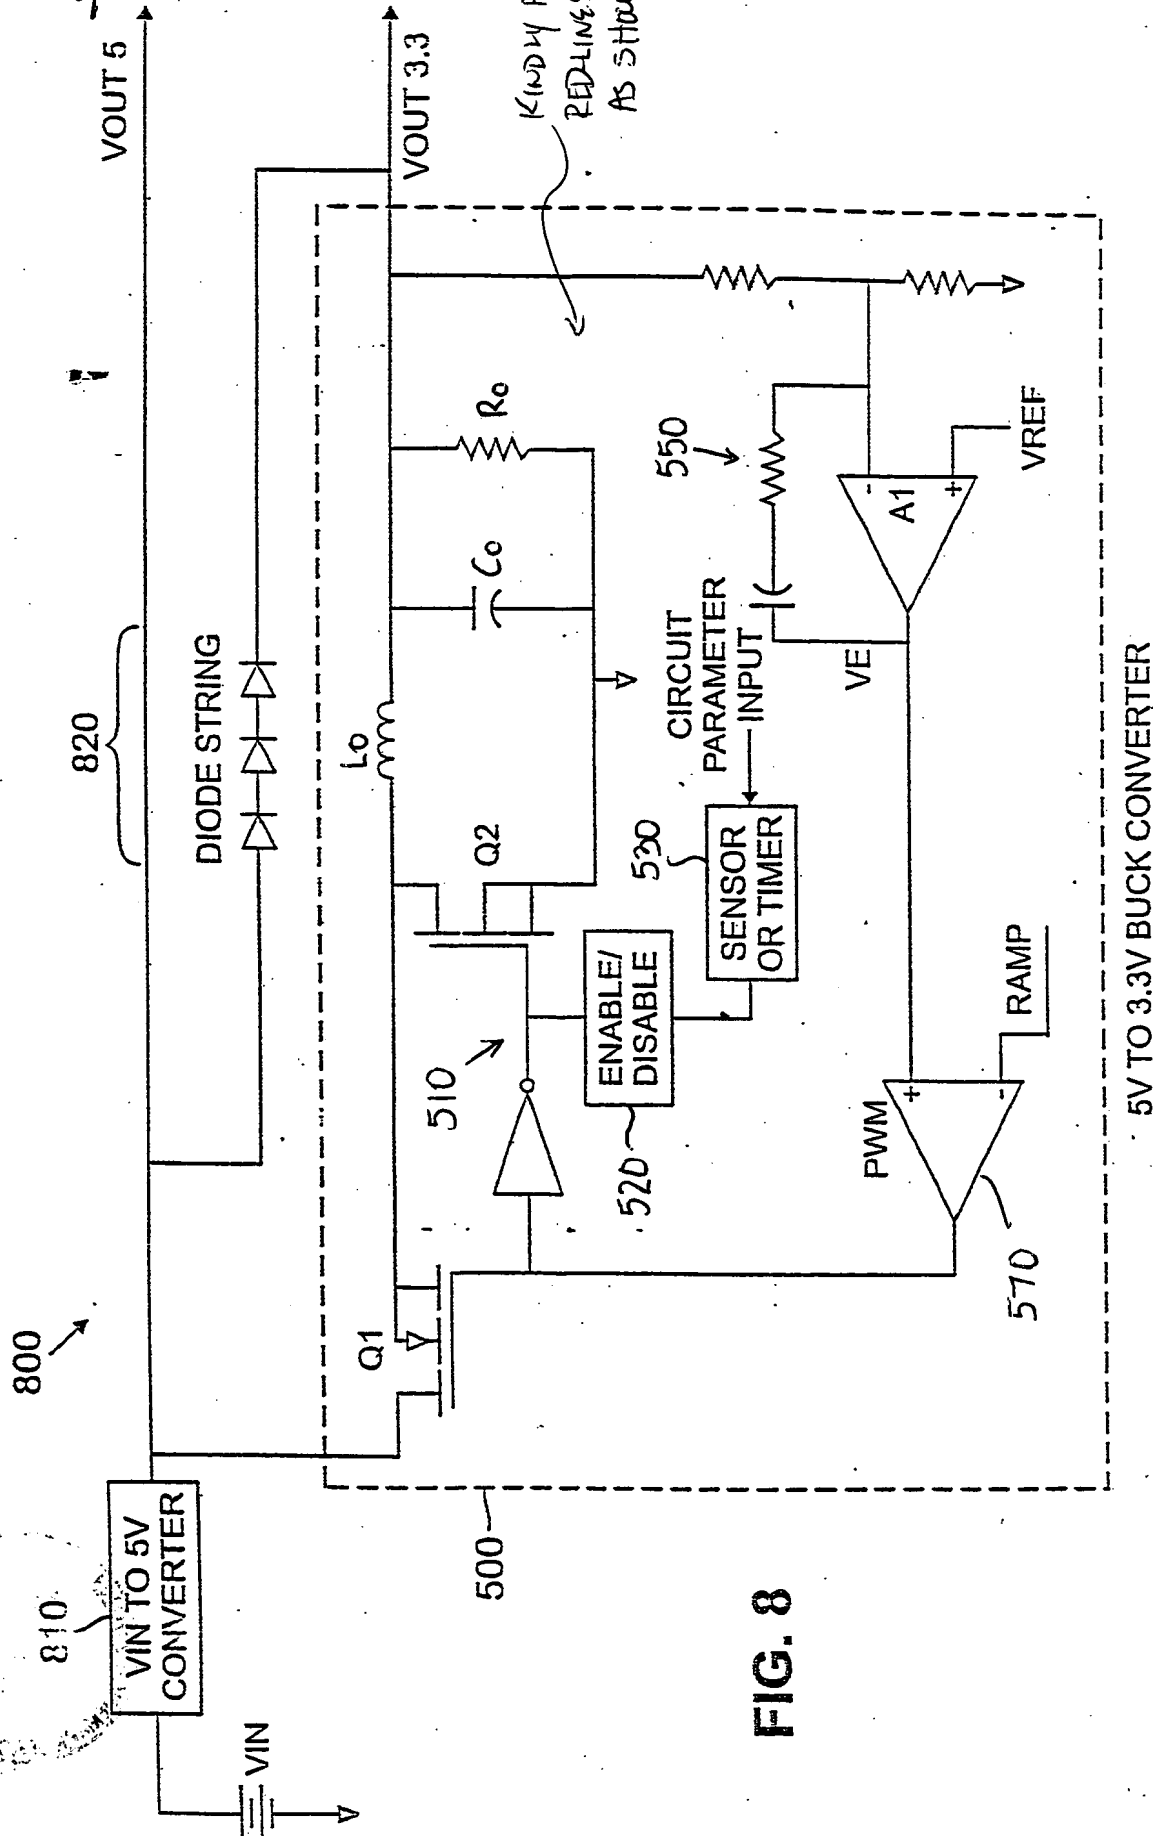


FIG. 8

8/8

11-32

KINDLY REPLACE
AS SHOWN

Approved
by BAs
6/2000

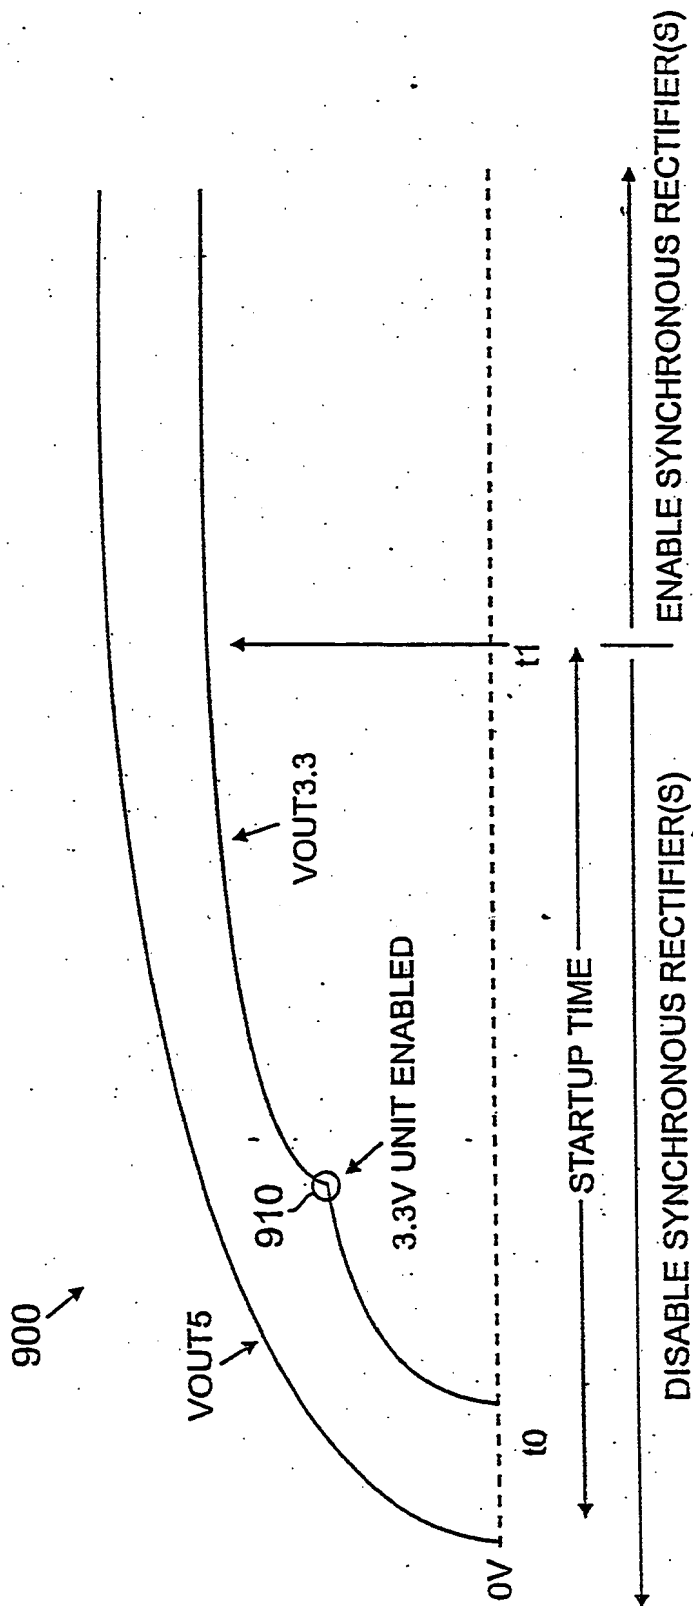


FIG. 9